
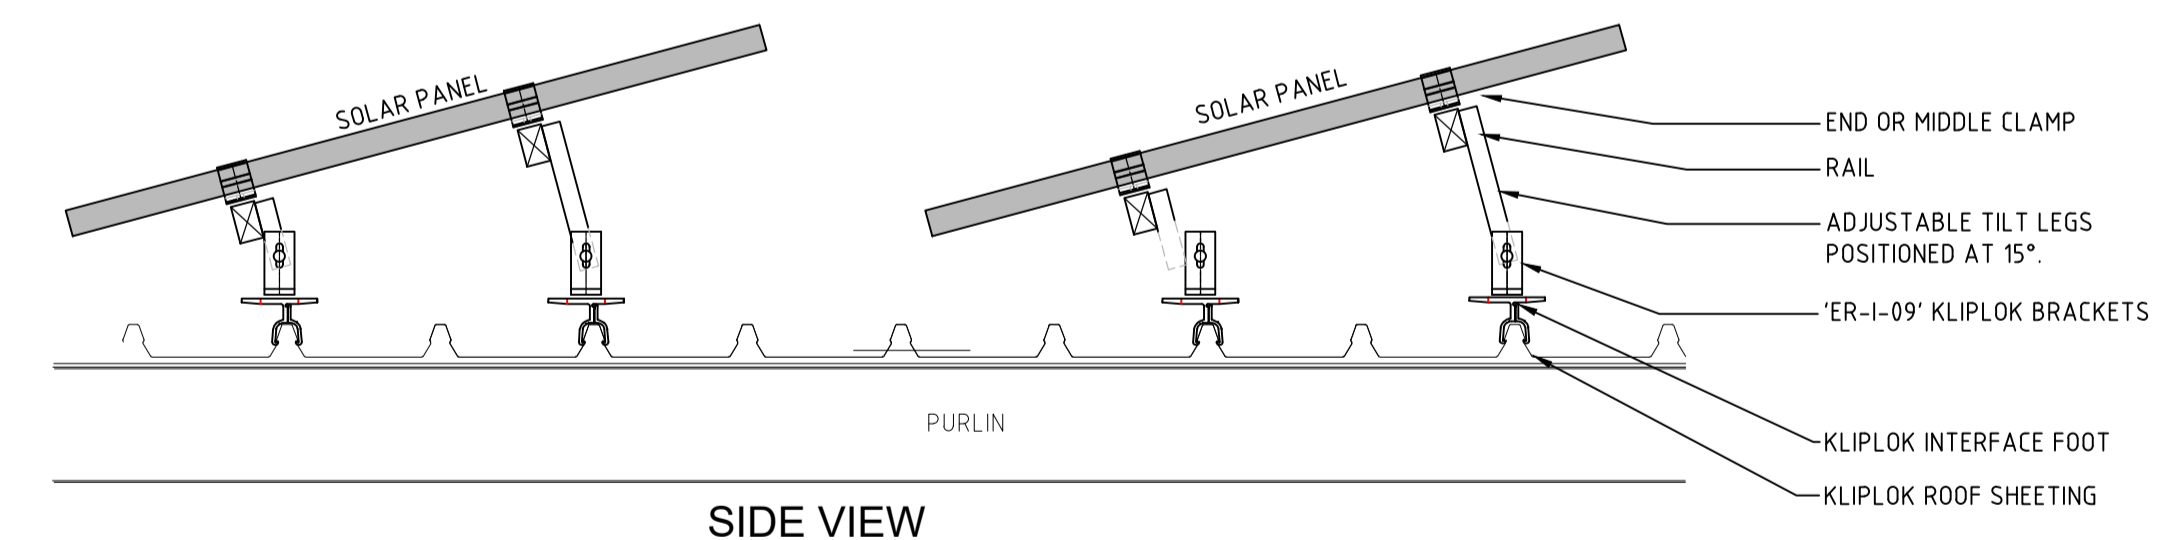


SOLAR PANEL STRING CIRCUIT SCHEDULE					
INVERTER No.	INVERTER MODEL	CHANNEL (INVERTER)	STRING COUNT	No OF PANELS	SOLAR PANEL MODEL
INV-01	SUN2000-29.9KTL (HUAWEI)	01	01	18	LONGI 450W (LR4-72HPH)
			02	18	LONGI 450W (LR4-72HPH)
			03	18	LONGI 450W (LR4-72HPH)

NOTE:
TOTAL SOLAR PANELS = 54

LEGEND OF SYMBOLS


- DENOTES ROOF MOUNTED SOLAR PANEL
- DENOTES EXISTING ROOF MOUNTED SOLAR PANEL
- DENOTES SOLAR PANEL STRING CIRCUIT NUMBER
- DENOTES INVERTER REFERENCE AND STRING NUMBER
- DENOTES ELECTRICAL CABLE TRAY ON ROOF
- DENOTES STRING 1
- DENOTES STRING 2
- DENOTES STRING 3
- DENOTES SOLAR PANEL MOUNTING RAIL
- DENOTES EXISTING EQUIPMENT

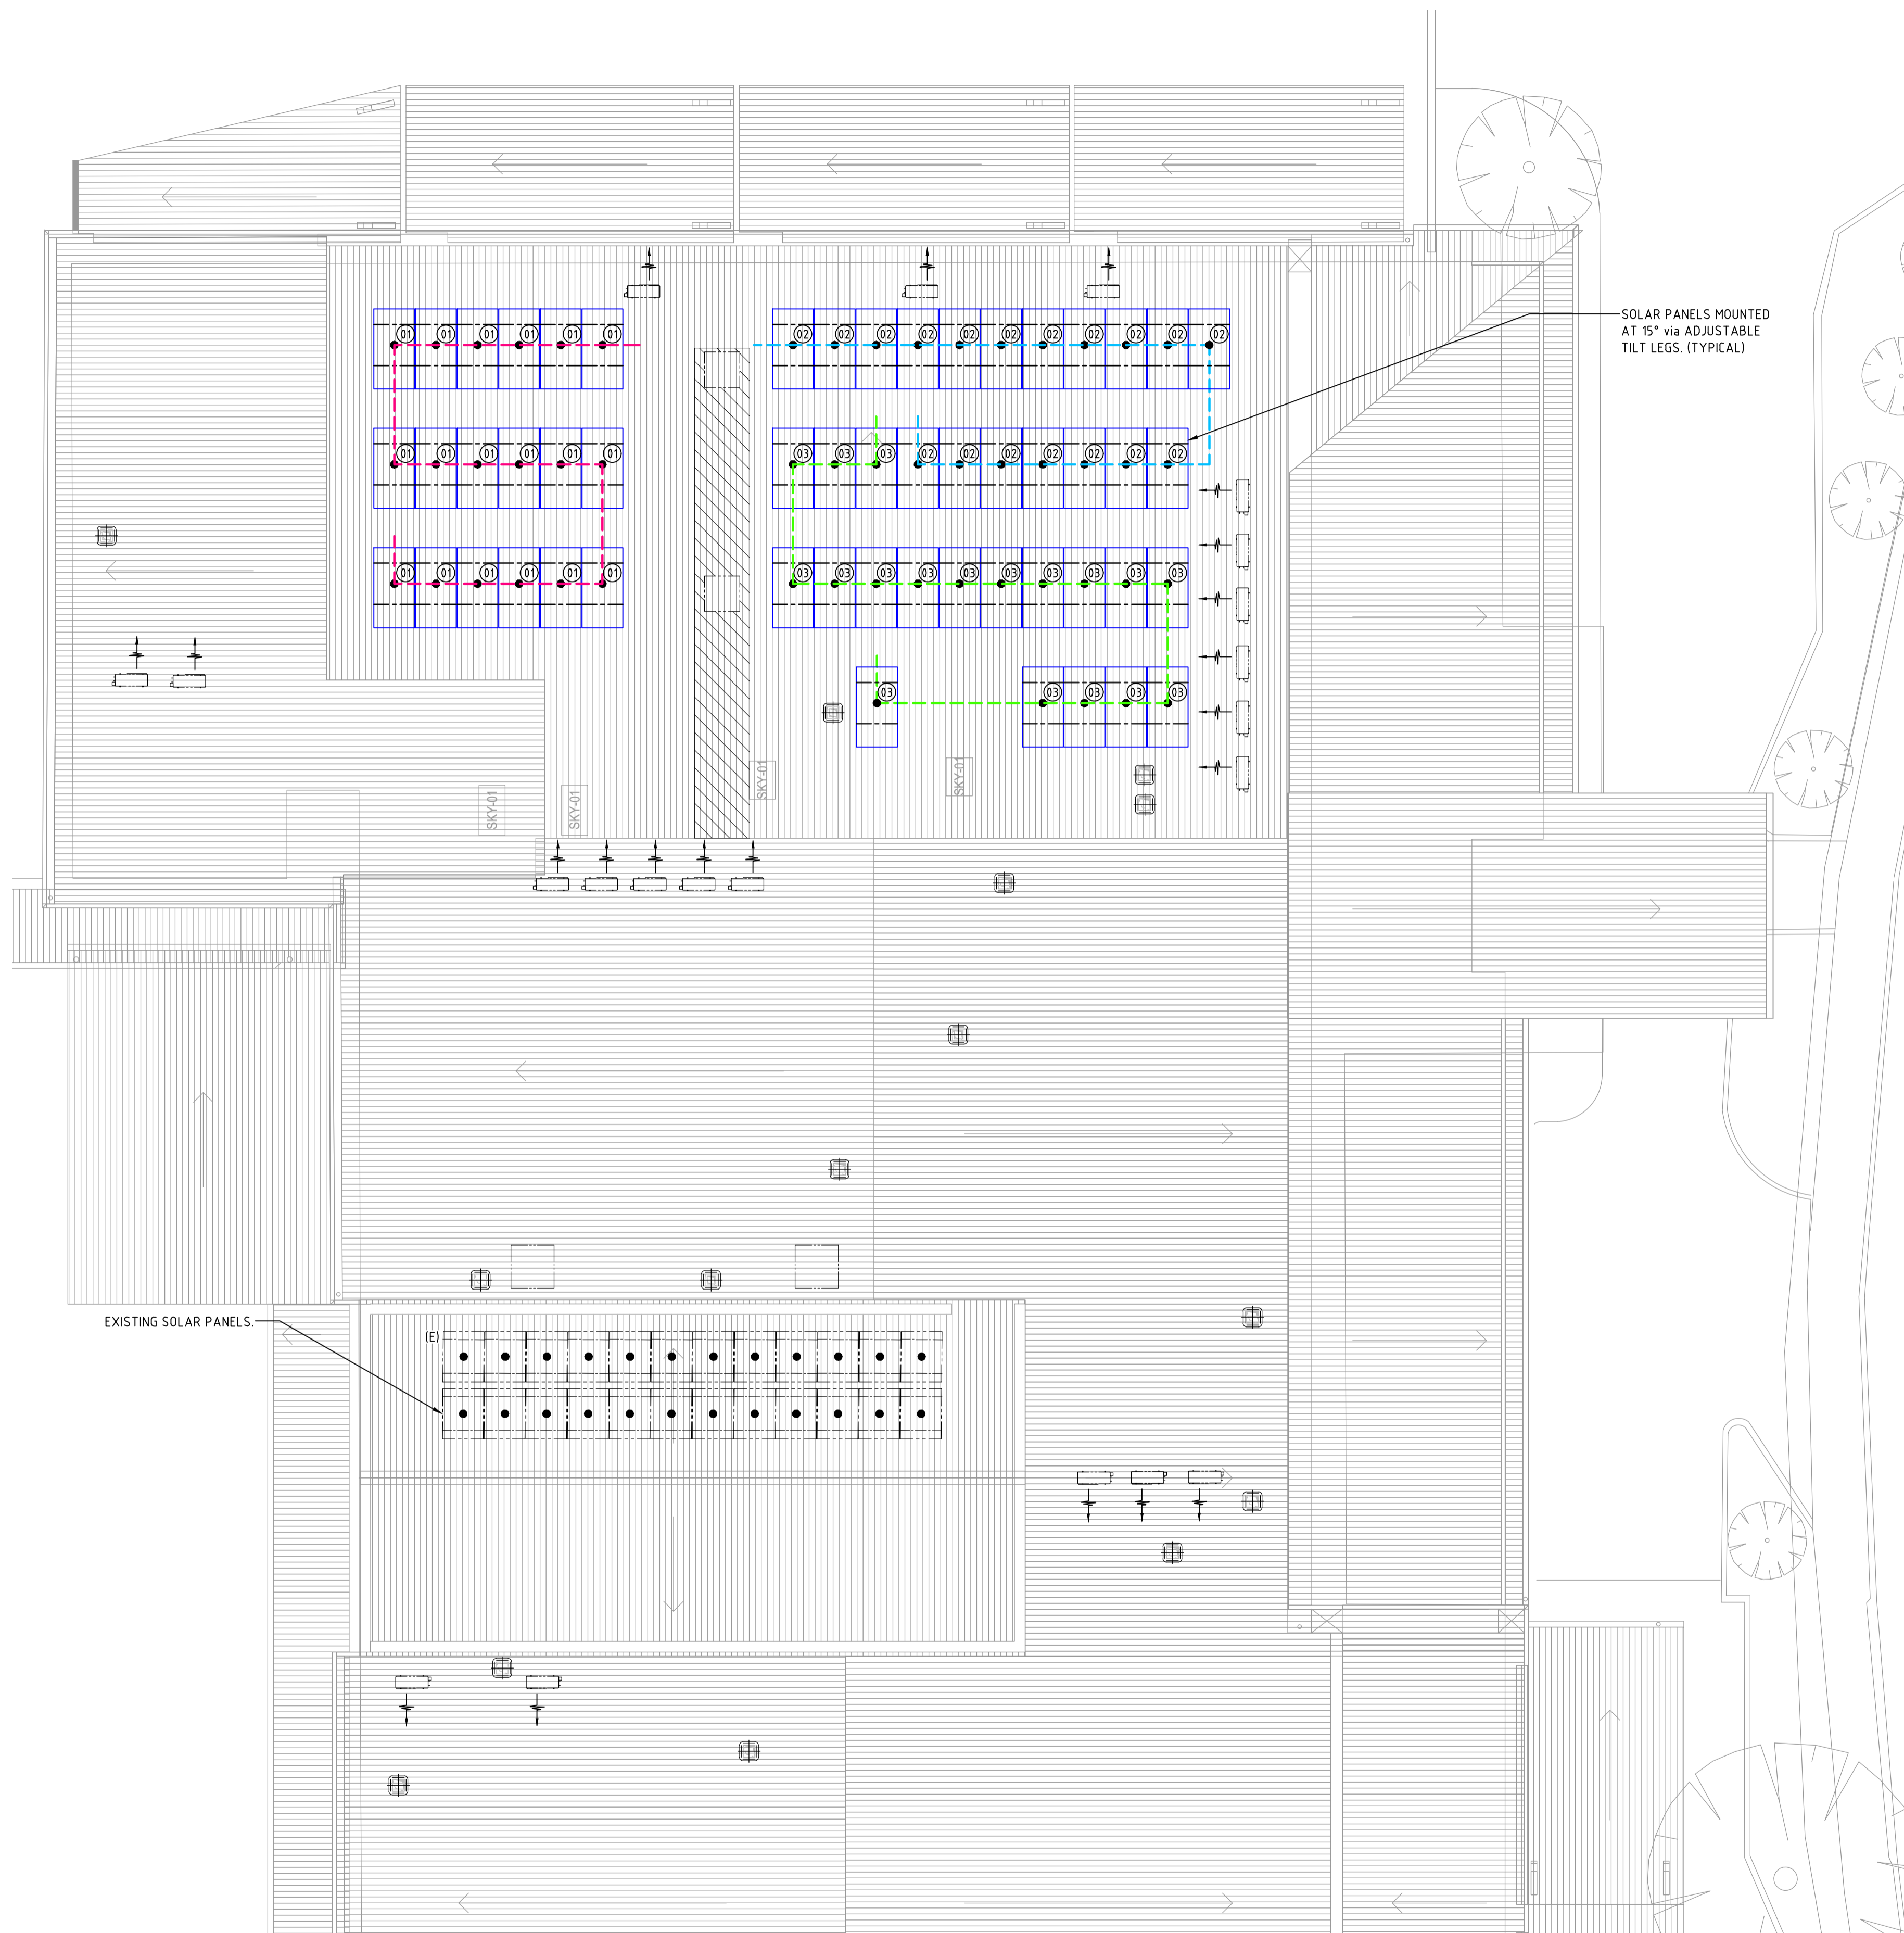


SOLAR PANEL MOUNTING - KLIPLOK ROOF SHEETING c/w ADJUSTABLE TILT LEGS
NTS

ROOF PLAN - SOLAR PANEL WIRING
SCALE 1:100

AS INSTALLED

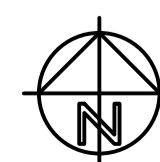

Rev.	Amendment	By	Date
A	AS INSTALLED	ALL	24/05/21
03	ISSUED FOR RE-APPROVAL - SOLAR PANELS ADJUSTED TO 15°	ALL	24/05/21
02	ISSUED FOR RE-APPROVAL - SOLAR PANEL MAKE AND MODEL CHANGE	ALL	19/05/21
01	ISSUED FOR APPROVAL	ALL	04/05/21

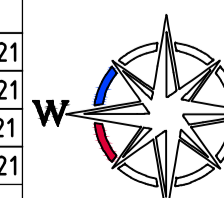

Westside Energy

11-13 West Thebarton Road, Thebarton, South Australia, 5031
ABN: 15 617 819 271 ACN: 617 819 271
T - 8451 2100 E - info@westsidegroup.com.au W - www.westsideenergy.com.au

Project		Drawn	Date	Scale
SUNDEN SPECIAL SCHOOL STAGE 02		A.L.L.	MAY 2021	AS SHOWN @ A1
Title		Checked	Designed	Approved
SOLAR ENERGY SETOUT, INSTALLATION DETAILS & SCHEDULES		P.S	C.B	
Drawing No		55046-E01		Issue
				A