



**SOLAR PANEL SCHEDULE**

STRING NUMBER	No. OF PANELS PER STRING	PANEL MAKE	PANEL DESCRIPTION	ASSOCIATED INVERTER
ST1-1	19	LONGI	LR4-72HPH (450W PANEL)	INV-1
ST1-2	19	LONGI	LR4-72HPH (450W PANEL)	INV-1
ST2-1	15	LONGI	LR4-72HPH (450W PANEL)	INV-1
ST2-2	15	LONGI	LR4-72HPH (450W PANEL)	INV-1
ST3-1	15	LONGI	LR4-72HPH (450W PANEL)	INV-1
ST4-1	19	LONGI	LR4-72HPH (450W PANEL)	INV-2
ST4-2	19	LONGI	LR4-72HPH (450W PANEL)	INV-2
ST5-1	15	LONGI	LR4-72HPH (450W PANEL)	INV-2
ST5-2	15	LONGI	LR4-72HPH (450W PANEL)	INV-2
ST6-1	15	LONGI	LR4-72HPH (450W PANEL)	INV-2
ST7-2	18	LONGI	LR4-72HPH (450W PANEL)	INV-3
ST8-1	16	LONGI	LR4-72HPH (450W PANEL)	INV-3
ST8-2	16	LONGI	LR4-72HPH (450W PANEL)	INV-3
ST9-1	16	LONGI	LR4-72HPH (450W PANEL)	INV-3
ST10-1	18	LONGI	LR4-72HPH (450W PANEL)	INV-4
ST10-2	18	LONGI	LR4-72HPH (450W PANEL)	INV-4
ST11-1	16	LONGI	LR4-72HPH (450W PANEL)	INV-4
ST11-2	16	LONGI	LR4-72HPH (450W PANEL)	INV-4
ST12-1	16	LONGI	LR4-72HPH (450W PANEL)	INV-4

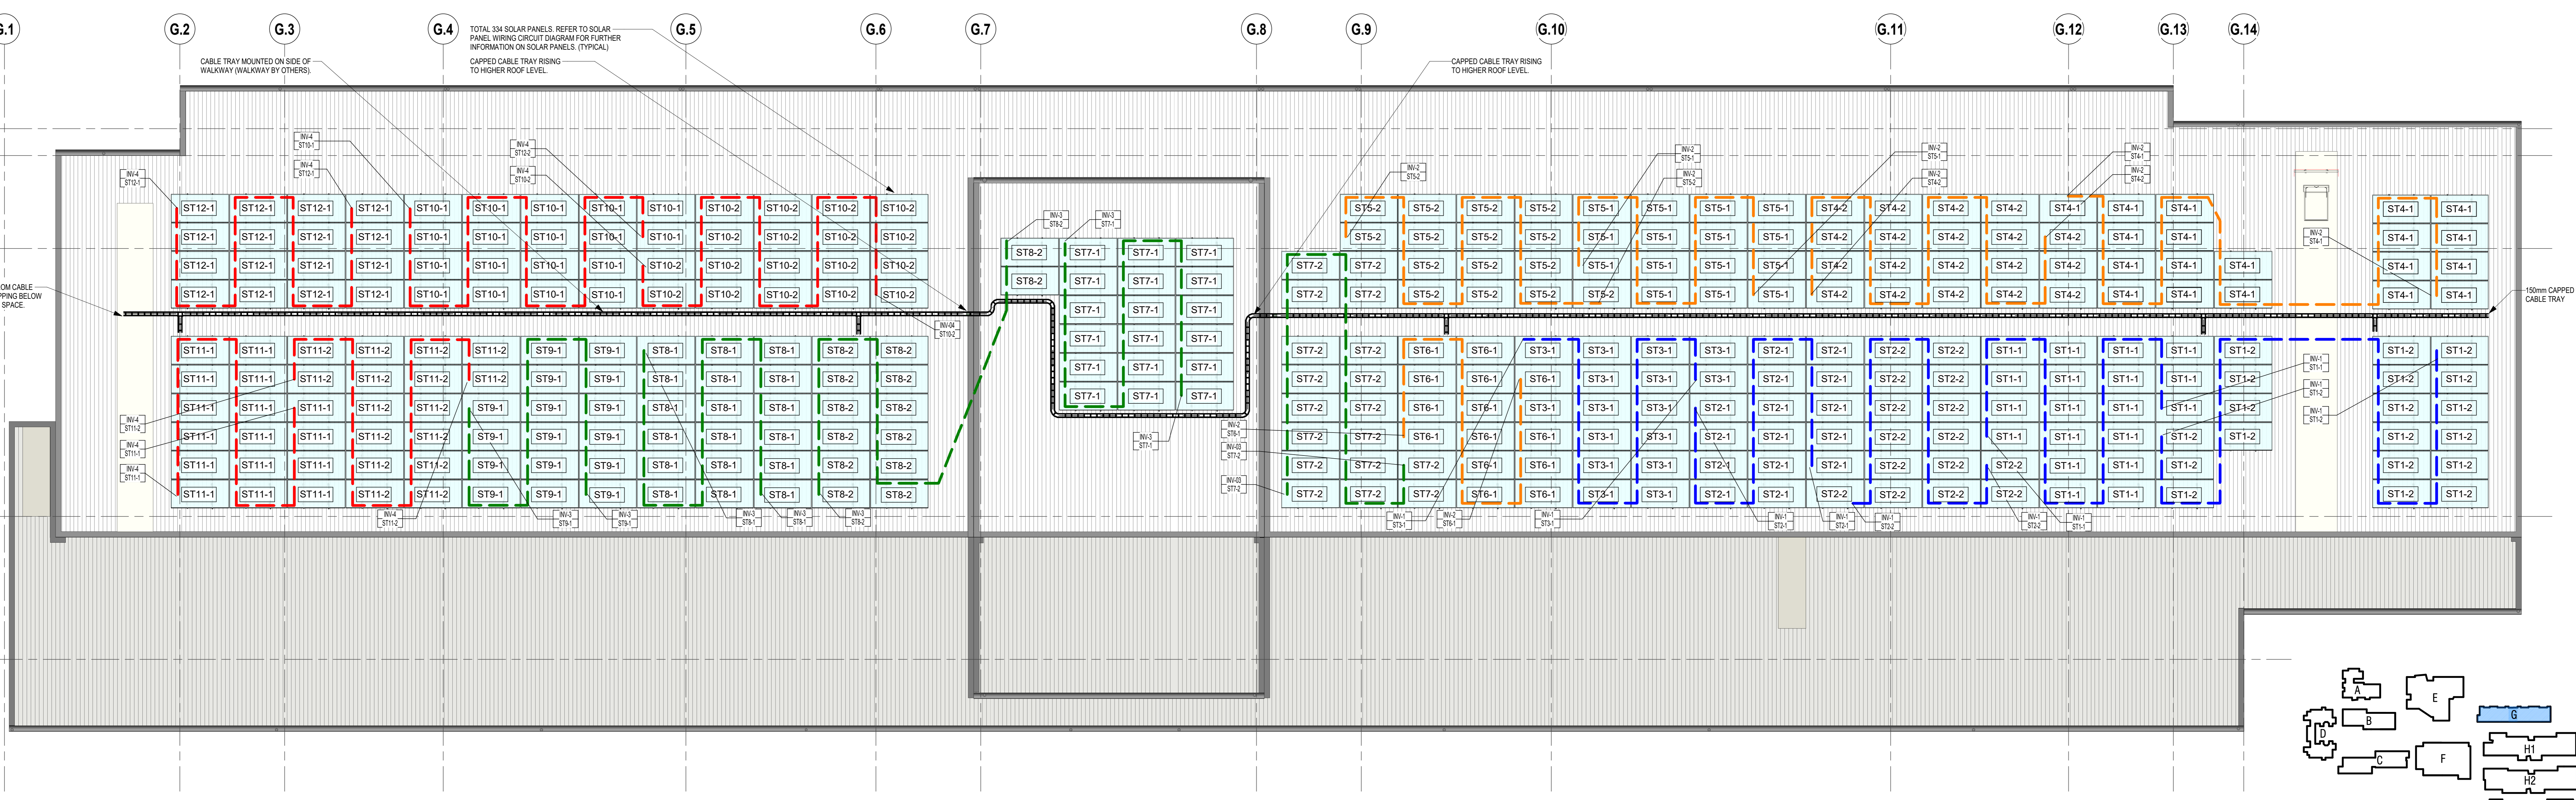

SOLAR PANEL LAYOUT  
1:100

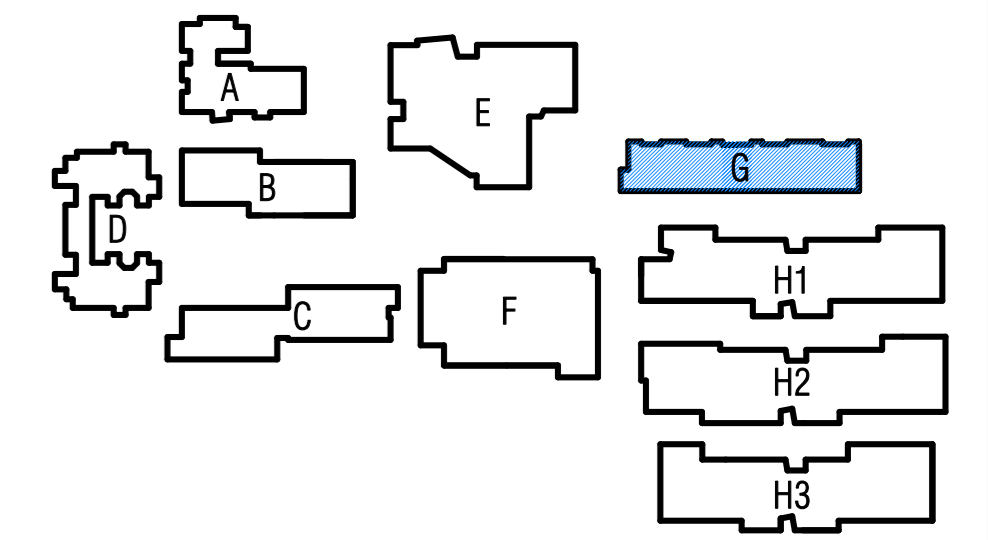

 	 11-13 WEST THEBARTON ROAD, THEBARTON, SA, 5031 PH: (08) 8451 2100 ABN: 85 747 515 257		Issue: AI Description: AS INSTALLED Date: 24/11/2021	<b>South Australian Schools Public Private Partnership</b> Government Of South Australia North Site - 23 Riverbanks Road, Anglevale South Site - 143 Port Road, Aldinga	<b>MECHANICAL SERVICES</b> ALDINGA - BUILDING G (INCLUSIVE 7-9) ROOF LAYOUT SOLAR PANEL LAYOUT Drawn: ALL Approved: P.S. Date: 24/11/2021	 <b>AS-INSTALLED</b> DRAWING NUMBER: SE-S-G101 REVISION: AI
			Scale: As indicated @ B1 Small text: ORIGINAL SHEET SIZE B1 PRINTED ON: 24/11/2021 4:13:58 PM			